


Basemaps:
 - UofWNC TN175 D.Kelley, D. Glickson 2004

Notes:
 - Extension Cable and Junction Box
 Coordinates are Provisional

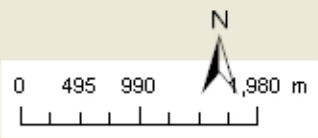

NEPTUNE Canada
Cabled Ocean Observatory

Barkley Canyon
 Extension Cable Layout
 26 July 2009

